


Keynote Legend	
Key Value	Keynote Text
3-07	6" THICK CONCRETE SLAB ON 2" SAND OVER 10 MIL. VISQUELEN VAPOR BARRIER WITH #5 @ 18" O.C. EACH WAY IN CENTER OF SLAB. (OMIT VISQUELEN IN SHOP AREA)

Revision		
Number	Description	Date
3	Plan Check Final	2-23-2015

PAD FOOTING SCHEDULE						
Mark	Type	Rebar Condition	Count	Detail	Project Volume	Width Length
P-1	3'-1" x 9'-6" x 2'-0" DEEP	(11) #4 BAR EW	16	130-D-1	814.00 CF	3'-1" 9'-6"
P-2	4'-0" SQ X 2'-0" DEEP	(9) #4 BAR EW	20	110-D-1	516.45 CF	4'-0" 2'-0"
F-1	Retaining Footing - 16" x 12"	(2) #4 BAR TOP AND BOT	4	120-D-1	1259.89 CF	1'-6"

Structural Column Schedule - Short (See Schedule Sheet)					
Size Type	Number	Type	Count	Column Length	
				Length (Finished w/ Plates)	Lower Detail Upper Detail
A	1	W24X98	1	21'-9"	120-D-1 150-D-1
A	2	W24X98	1	21'-9"	110-D-1 150-D-1
A	3	W24X98	1	23'-2"	130-D-1 140-D-1
A	4	W24X98	1	21'-9"	110-D-1 150-D-1
A	5	W24X98	1	21'-9"	110-D-1 150-D-1
A	6	W24X98	1	21'-9"	110-D-1 150-D-1
A	7	W24X98	1	19'-8"	110-D-1 150-D-1
A	8	W24X98	1	19'-8"	110-D-1 150-D-1
A	9	W24X98	1	19'-8"	110-D-1 150-D-1
A	10	W24X98	1	20'-6"	130-D-1 140-D-1
A	11	W24X98	1	20'-6"	130-D-1 140-D-1
A	12	W24X98	1	20'-6"	130-D-1 140-D-1
A	13	W24X98	1	19'-8"	110-D-1 150-D-1
A	14	W24X98	1	20'-6"	130-D-1 140-D-1
A	16	W24X98	1	23'-2"	130-D-1 140-D-1
A	18	W24X98	1	23'-2"	130-D-1 140-D-1
A	19	W24X98	1	23'-2"	130-D-1 140-D-1
A	20	W24X98	1	23'-2"	130-D-1 140-D-1
A	21	W24X98	1	21'-9"	110-D-1 150-D-1
A	22	W24X98	1	23'-2"	130-D-1 140-D-1
A	23	W24X98	1	20'-6"	130-D-1 140-D-1
A	24	W24X98	1	21'-9"	110-D-1 150-D-1
A	25	W24X98	1	23'-2"	130-D-1 140-D-1
A	26	W24X98	1	23'-2"	130-D-1 140-D-1
A	27	W24X98	1	21'-9"	110-D-1 150-D-1
A	28	W24X98	1	23'-2"	130-D-1 140-D-1
A	29	W24X98	1	21'-9"	110-D-1 150-D-1
A	30	W24X98	1	23'-2"	130-D-1 140-D-1
A	31	W24X98	1	19'-8"	120-D-1 150-D-1
B	7	W18X76	2	20'-2"	110-D-1 270-D-1
B	17	W18X76	4	22'-8"	110-D-1 270-D-1
Grand Total					

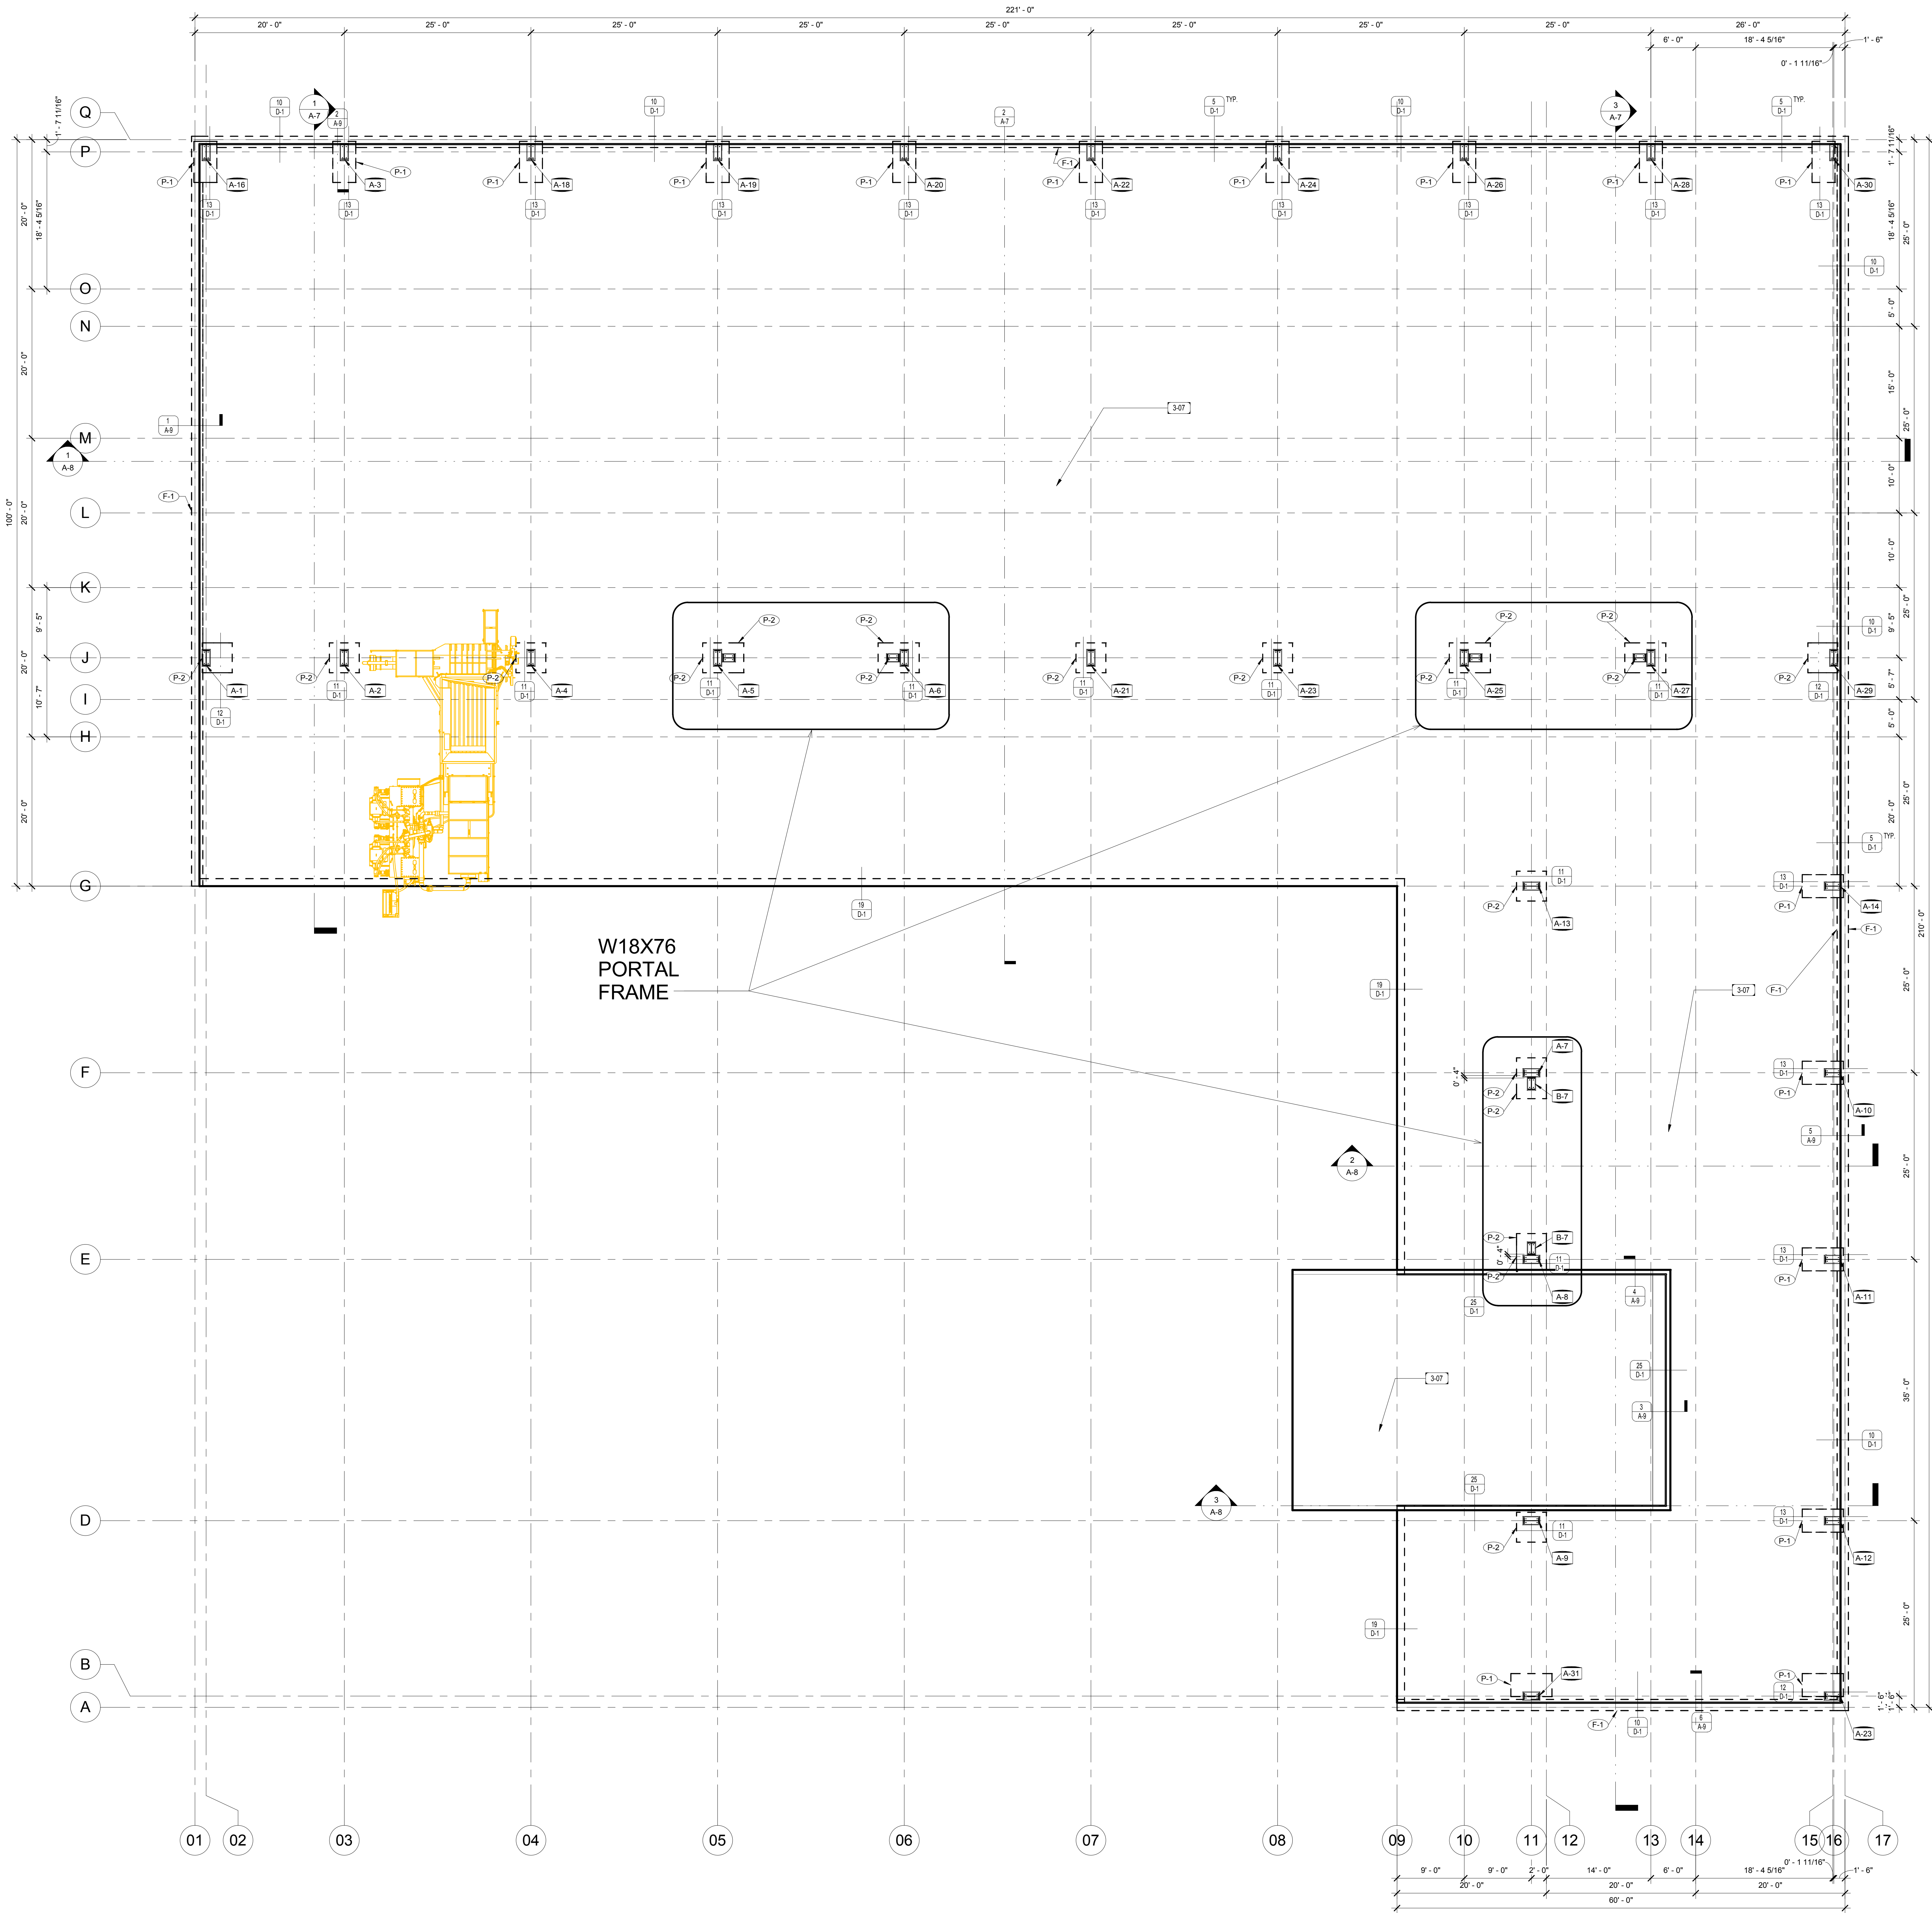

1 FOUNDATION PLAN
1/8" = 1'-0"

Recycling Center For:
**HOISTON INT'L
ENTERPRISES INC.**

13-940

6-26-14

2192 W. HIGHLAND AVE. SAN
BERNARDINO, CA 92407

S-1