



Number	Revision	Description	Date
1		Plan Check #2	10-13-2014
2		Plan Check #3 Final	2-23-2015


185 05-000 Angle Splice
1 1/2" = 1'-0"

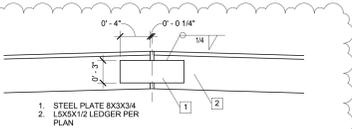


NOTE: PROVIDE CONTROL JOINTS AT 15'-0" MAX. EACH WAY (U.O.N.) PROVIDE SAW CUT WITHIN 24 HOURS OF POUR

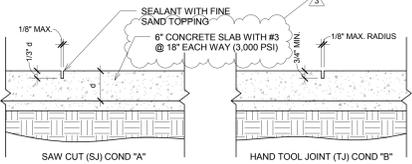


184 TYP. CONTROL JOINT
1" = 1'-0"

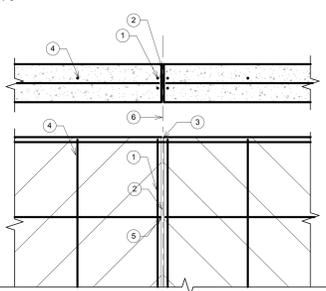


183 03 - A - Conc. Wall Control Joint
1" = 1'-0"

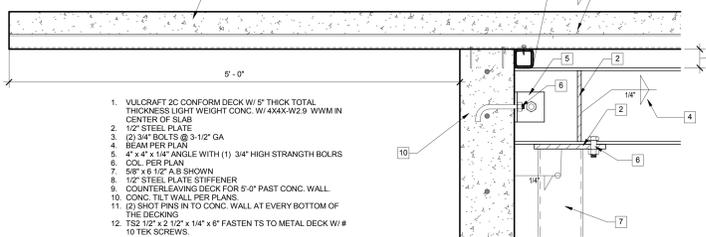


177 05-003 Floor Beam to Beam @ Deck Cont.
1 1/2" = 1'-0"

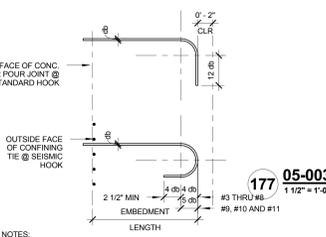

182 03 - A - Conc. Hook Detail
1 1/2" = 1'-0"

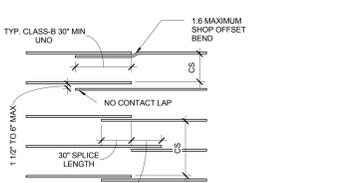


181 03 - A - Conc. Bar Slice Details
1 1/2" = 1'-0"

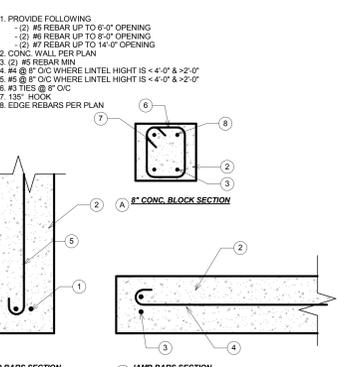


180 03 - A - Conc. 8" Wall Head & Jamb Detail
1 1/2" = 1'-0"


175 05-002 Floor Col. to Beam @ Edge
1 1/2" = 1'-0"

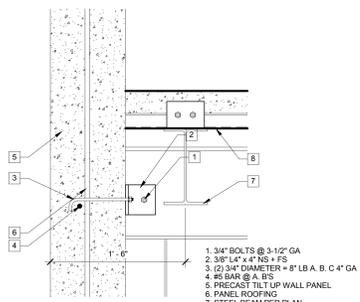


176 05-002 Floor Beam to Beam @ Edge
1 1/2" = 1'-0"

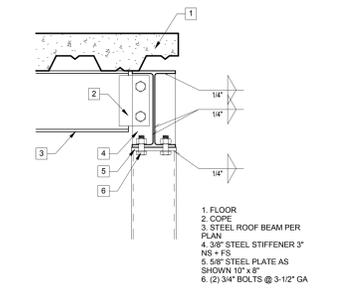


179 03 - A - Conc. 8" Openings
1/2" = 1'-0"

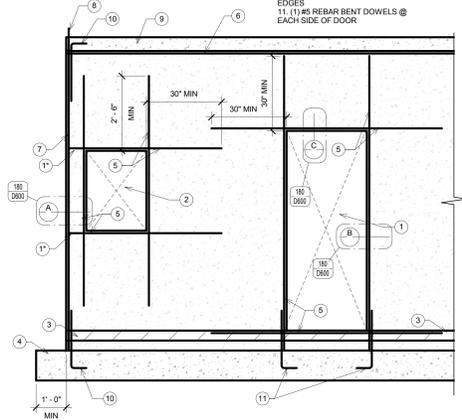


174 05-001 Floor Beam to Beam @ Edge
1 1/2" = 1'-0"

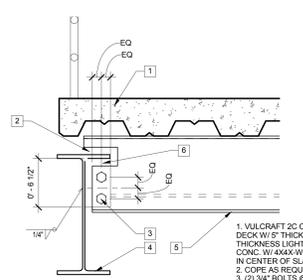


173 05-000 Truss to Wall
1 1/2" = 1'-0"

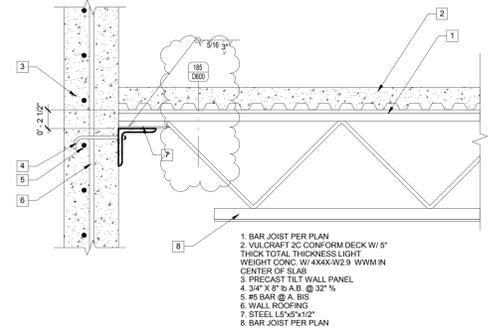

172 05-000 Truss to Wall1
1 1/2" = 1'-0"

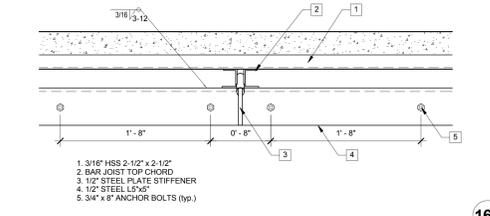


171 05-000 Truss to Angle
1 1/2" = 1'-0"

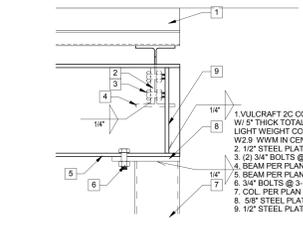


170 05-000 Floor Col. to Beam @ Edge
1 1/2" = 1'-0"




155 05-000 Floor Beam to Beam @ Col.
1 1/2" = 1'-0"

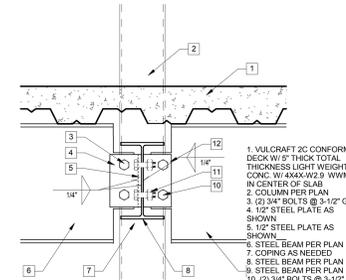


166 05-000 Floor Beam to Beam @ Cor. Col. with Truss
1 1/2" = 1'-0"

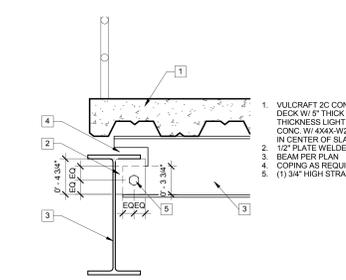

167 05-000 Floor Beam to Beam @ Edge
1 1/2" = 1'-0"

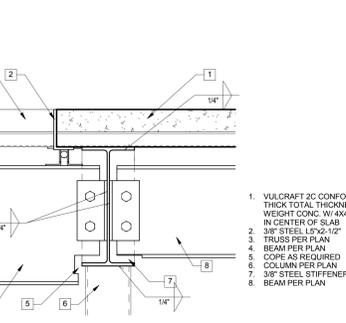


168 05-000 Floor Beam to Beam @ Edge Corner
1 1/2" = 1'-0"

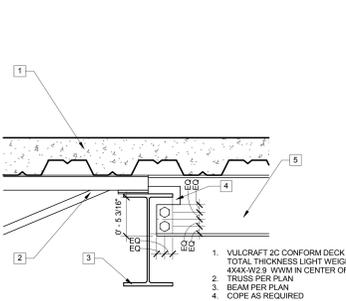


169 05-000 Floor Beam to Truss @ Edge
1 1/2" = 1'-0"




154 05-000 Floor Beam to Beam @ Col.1
1 1/2" = 1'-0"

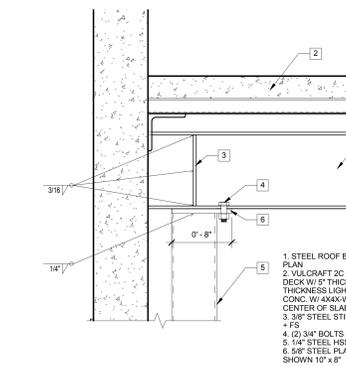


153 05-000 Beam to Col.
1 1/2" = 1'-0"

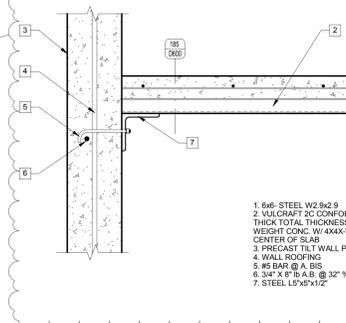

152 05-000 Angle to Deck
1 1/2" = 1'-0"

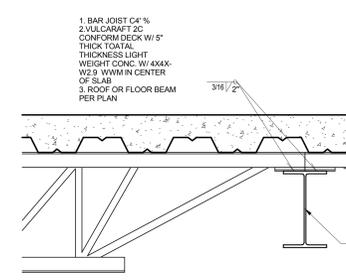

151 05 - 000 Floor Beam to Truss Detail
1 1/2" = 1'-0"

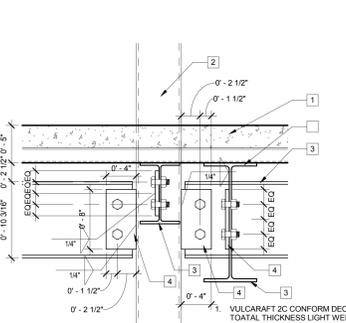

150 05 - 000 Floor Beam to Col. Detail
1 1/2" = 1'-0"



Recycling Center For:
HOUSTON INT'L ENTERPRISES INC.

13-940
 6-31-14

2192 W. HIGHLAND AVE. SAN BERNARDINO, CA 92407

D600

Details